

E-FILE STAMP

Fill in with amendment plan number

The cover sheet should be an updated plan that reflects the changes in the amendment. It should contain the same information as the original plan's cover sheet, only with updated file numbers and clerical information, a new sheet index, and a list of amendment items.

AMENDMENT NO.	AMENDMENT TITLE
AMENDMENT NO.	AMENDMENT TITLE
AMENDMENT NO.	AMENDMENT TITLE
CONTEXT MAP GOES HERE	
AMENDMENT LIST List and number all non- clerical changes occurring as part of the current amendment.	

List and number all non-clerical changes occurring as part of the current amendment.

Provide a sheet index that contains all pages of the original plan. Mark sheets that are changing with the current amendment with a single asterisk, and mark sheets that have been added with the current amendment with two asterisks.

- *SP-1 Cover Sheet
- *SP-2 Site Plan
- *SP-3 Site Plan
- SP-4 Site Plan Details
- SP-5 Site Plan Details
- SP-6 Site Plan Details
- **SP-7 Site Plan Details

*Sheets revised under this amendment

**Sheets added under this amendment

1. 2,500 SF BUILDING ADDITION
2. CHANGE IN MATERIALS AND MASONRY FACADES
3. CHANGES TO PAVING, AND FENCES
4. UTILITY LAYOUT REFINEMENT AND ANY ASSOCIATED CHANGE TO LODS
5. CHANGE TO HARDSCAPE DESIGN
6. CHANGE TO RECREATION TABLES

GENERAL NOTES

1. NOTES NOTES NOTES NOTES
2. NOTES NOTES NOTES NOTES
3. NOTES NOTES NOTES NOTES
4. NOTES NOTES NOTES NOTES
5. NOTES NOTES NOTES NOTES
6. NOTES NOTES NOTES NOTES
7. NOTES NOTES NOTES NOTES
8. NOTES NOTES NOTES NOTES
9. NOTES NOTES NOTES NOTES
10. NOTES NOTES NOTES NOTES
11. NOTES NOTES NOTES NOTES
12. NOTES NOTES NOTES NOTES

Clerical information, such as changes to the design team and plan numbers, should be updated for the new amendment, but these changes do not need to be shown in the amendment list.

FIRM NAME, LLC
FIRM ADDRESS, SUITE #
FIRM CITY, STATE, ZIP
PHONE: () -

PREPARED FOR:
DIFFERENT OWNER, LLC
111 ROCKVILLE PIKE
SUITE 100
ROCKVILLE, MD
301.111.1112
CONTACT: JOE SCHMO

DESIGN CONSULTANTS

ARCHITECTS
NEW ARCHITECTURE FIRM
9911 BUILDING ROAD
SUITE 101
ARLINGTON, VA
703.222.1234
CONTACT: JOHN DOE

ATTORNEY
DUMMY LAW FIRM
9999 LAW ROAD
SUITE 700
BETHESDA, MD
301.999.9999
CONTACT: JANE DOE

TRAFFIC ENGINEER
DUMMY TRAFFIC CONSULTANT
9999 TRAFFIC STREET
BALTIMORE, MD
410.999.1111
CONTACT: JOHN DOE

UTILITY ENGINEER
DUMMY UTILITY COMPANY
999 UTILITY DRIVE
WASHINGTON, DC
202.911.9911
CONTACT: JANE DOE

[illegible]

PARCELA A

(EXAMPLE SUBDIVISION)
4TH ELECTION DISTRICT
MONTGOMERY COUNTY,
MARYLAND
WSSC GRID: 201NW01
TAX MAP: AA11

SITE PLAN
#820XX00XA

DRAWN BY: PDS
DESIGNED BY: PDS
DATE ISSUED: _____

SHEET NO. SP-1

Create a new professional certificate and developer's certificate, filled out with the amendment plan number and proper information, but do not provide a signature on the electronic versions.


I hereby certify that these documents were prepared or approved by me, and that I am a duly licensed Professional Engineer under the laws of the State of Maryland.

Signature _____ Date _____
NEW PROFESSIONAL
 Printed Name _____ December 18, 2018
 Title: Associate _____ Expiration Date _____
 License No. XXXXX

The undersigned agrees to execute all the features of the Site Plan Approval No. 820XX00XA, including Approval Conditions, Development Program, and Certified Site Plan.

Developer's Name: DIFFERENT OWNER LLC
Contact Person: Joe Schmo, Vice President
Address: 111 Rockville Pike, Rockville, MD, 20847
Phone: 301-111-1112

Signature: _____ Date: _____

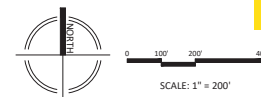

E-FILE STAMP

	D1	D2	D3	D4	D5
	Teachers	Children	Teens	Adults	Seniors
SFD 1 (20 000 sf+)	0 100	0 200	0 220	0 060	0 080
SFD 3 (7 000-16 999 sf)	0 130	0 240	0 240	0 080	0 110
SFD 4 (>7 000 sf)	0 140	0 190	0 230	1 270	0 130
TOWNHOUSE	0 170	0 230	0 180	1 350	0 090
GARAGE (up to 4 storage)	0 110	0 140	0 220	1 180	0 060
HARSE (>5 storage)	0 040	0 040	0 040	0 770	0 460

DEMAND CALCULATIONS						
	Number of Units	D1 Totals	D2 Children	D3 Teens	D4 Adults	D6 Seniors
TOWNHOUSE	43	7.3	9.5	7.7	55.5	3.9
Total Units	43.0					
Total Demand		7.3	9.6	7.7	56.6	3.9
On-Site Supply		5.7	7.8	10.6	61.1	12.1
% Demand Met On-Site		78.4	82.9	136.9	110.1	313.4
Off-Site % of Demand		2.6	3.3	2.2	44.4	7.4
Total On-Site & Off-Site Supply		8.3	11.1	12.3	80.5	13.3
% Demand Met On-Off		113.4	117.0	171.9	146.1	348.8
Off-Site % of Demand		35%	35%	35%	35%	35%
Off-Site % of Supply		31%	30%	20%	24%	10%
*must not exceed 35% in any column						

When changes are made to a table, include change triangles next to the rows of the table that have changed.

The black and white drawings are new drawings that reflect the revisions made as part of the amendment. These drawings will replace the old pages in the certified plan set. These sheets should be named with the codes BSITE/BPREL, BLL, BARCH, or BFCP.

Recreate the full list of amendment changes in black on every black and white page. Only put triangles around the changes that are present on the current page.

Black and white drawings should be clean versions of the resulting plan after amendment changes have been made. Include change triangles near the affected areas that correspond with the amendment list.



1. 2,500 SF BUILDING ADDITION
2. CHANGE IN MATERIALS AND MASONRY FACADES
3. CHANGES TO PAVING, AND FENCES
4. UTILITY LAYOUT REFINEMENT AND ANY ASSOCIATED CHANGE TO LODS
5. CHANGE TO HARDSCAPE DESIGN
6. CHANGE TO RECREATION TABLES


Clerical information, such as changes to the design team and plan numbers, should be updated for the new amendment, but these changes do not need to be shown in the amendment list.

AMENDMENT
EXAMPLE
PARCEL A
(EXAMPLE SUBDIVISION)
4TH ELECTION DISTRICT
MONTGOMERY COUNTY,
MARYLAND
WSSC GRID: 201NW01
TAX MAP: AA11
SITE PLAN
#820XX00XA

DRAWN BY: PDS
DESIGNED BY: PDS
DATE ISSUED: 12/29/17

SHEET
NO. SP-7

Plan should have a new space for professional signature, developer's certificate, and M-NCPPC approval stamp. Remove any previous approvals or signatures from the black and white plans.

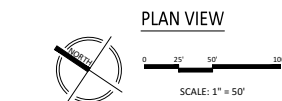

I hereby certify that these documents were prepared or approved by me,
and that I am a duly licensed Professional Engineer under the laws of the
State of Maryland.

Signature _____	Date _____
NEW PROFESSIONAL _____	December 18, 2018 _____
Printed Name _____	Expiration Date _____
Title: Associate _____	
License No. 11111 _____	

The undersigned agrees to execute all the features of the Site Plan Approval No. 0200C000XA, including Approval Conditions, Development Program, and Certified Site Plan.


Developer's Name: DIFFERENT OWNER, LLC

Contract Person: JOE SCHMO

Address: 111 ROCKVILLE PIKE, SUITE 100

Phone: 301.111.1112

Signature: _____ Date: _____

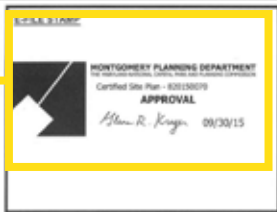

Recreation Calculations					
	D1 Totals	D2 Children	D3 Teens	D4 Adults	D5 Seniors
SPD 1 (25,000 sq ft)	0.100	0.000	0.000	0.000	0.000
SPD 2 (7,000 sq ft)	0.100	0.000	0.000	0.000	0.000
SPD 3 (7,000 sq ft)	0.100	0.000	0.000	0.000	0.000
SPD 4 (7,000 sq ft)	0.100	0.000	0.000	0.000	0.000
SPD 100 (7,000 sq ft)	0.100	0.000	0.000	0.000	0.000

DEMAND CALCULATIONS						
	Number of Units	D1 Totals	D2 Children	D3 Teens	D4 Adults	D5 Seniors
TOWNSHIP	40	7.3	0.5	7.7	55.3	3.3
Total Demand	40.0	7.3	0.5	7.7	55.3	3.3
On-Site Supply	5.7	7.3	0.5	10.0	0.1	1.2
% Demand Met On-Site	76.4	82.3	100.0	101.1	0.1	36.4
Off-Site Supply	2.6	3.3	2.7	18.4	1.4	0.0
Total On-Site & Off-Site Supply	8.3	11.1	10.5	85.3	13.3	13.2
% Demand Met Off-Site	110.4	107.3	107.3	107.3	107.3	107.3
Off-Site % of Demand*	30%	30%	30%	30%	30%	30%
Off-Site % of Supply*	31%	30%	30%	30%	24%	0%
*Must not exceed 30% in any column						

CHANGES TO TABLES

When changes are made to a few figures in a table, include change triangles next to the rows of the table that are changing, and use red change clouds to show which numbers have changed. If the whole table is being changed as part of the amendment, draw a red cloud around the entire table with a single change triangle next to it.

EXPLICIT CHANGES TO DRAWINGS

As much as possible, show amendment changes by superimposing the new project details in red on top of the previously approved plans. Include change triangles near the affected areas that correspond with the amendment list.

REDLINED DRAWINGS


The redline drawings should use the previously approved plans as the background, with redlined changes overlaid on top of the old plans. This plan is for reviewer reference only. These sheets should be named with the codes RPREL/RSITE, RLL, RARCH or RFCP.

AMENDMENT LIST

Recreate the full list of amendment changes in red on every page. Put triangles around the changes that are present on the current page.

IMPLICIT CHANGES TO DRAWINGS

In instances where changes cannot be shown by superimposing new project details on top of the old plan, the areas where changes occur should be called out with red change clouds, as well as with change triangles that correspond with the amendment list.

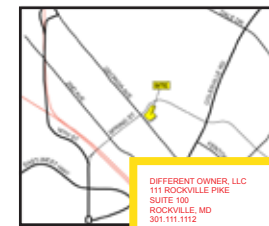

Plan Preparer

FIRM NAME, LLC
FIRM ADDRESS, SUITE #
FIRM CITY, STATE, ZIP
PHONE: () - -

PREPARED FOR:
DUMMY-OWNER-LLC
999 ROCKVILLE PIKE
SUITE 100
ROCKVILLE, MD
20854-1111
CONTACT: JOE SCHMO

DESIGN CONSULTANTS

ARCHITECTS:
DUMMY-ARCHITECTS
9991 BUILDING ROAD
SUITE 101
ARLINGTON, VA
22202-1234
JOHN DOE

ATTORNEY:
DUMMY LAWYERS
9999 LAW ROAD
SUITE 700
BETHESDA, MD
20814-1234
CONTACT: JANE DOE

TRAFFIC ENGINEER:
DUMMY TRAFFIC
9999 TRAFFIC STREET
BALTIMORE, MD
21201-1234
CONTACT: JOHN DOE

UTILITY ENGINEER:
DUMMY UTILITY
999 UTILITY DRIVE
WASHINGTON, DC
20001-1234
CONTACT: JANE DOE

LIST OF AMENDMENT ITEMS

- 2,500 SF BUILDING ADDITION
- CHANGE IN MATERIALS AND MASONRY FACADES
- CHANGES TO PAVING, AND FENCES
- UTILITY LAYOUT REFINEMENT AND ANY ASSOCIATED CHANGE TO LODS
- CHANGE TO HARDSCAPE DESIGN
- CHANGE TO RECREATION TABLES

DATE	REVISIONS
08/30/15	1. SITE PLAN (08/30/15)

AMENDMENT EXAMPLE



PARCELA
(EXAMPLE SUBDIVISION)
4TH ELECTION DISTRICT
MONTGOMERY COUNTY,
MARYLAND
WSSC GRID: 201NW01
TAX MAP: AA11

SITE PLAN
#820XX00X0A

EXAMPLE PLAN

DRAWN BY: PDS
DESIGNED BY: PDS
DATE ISSUED: 12/29/17

SHEET NO. SP-7

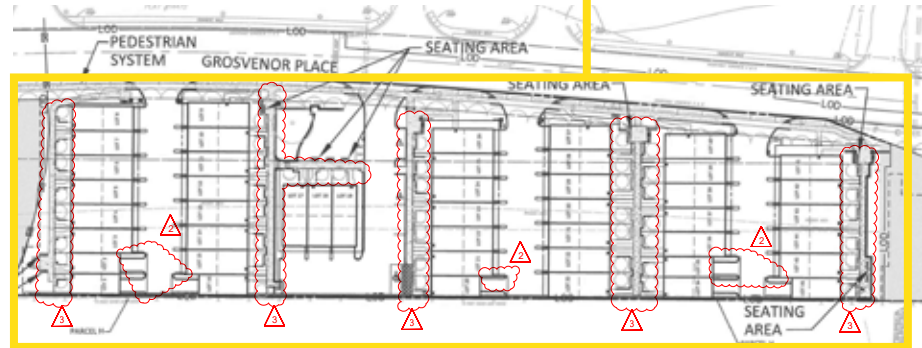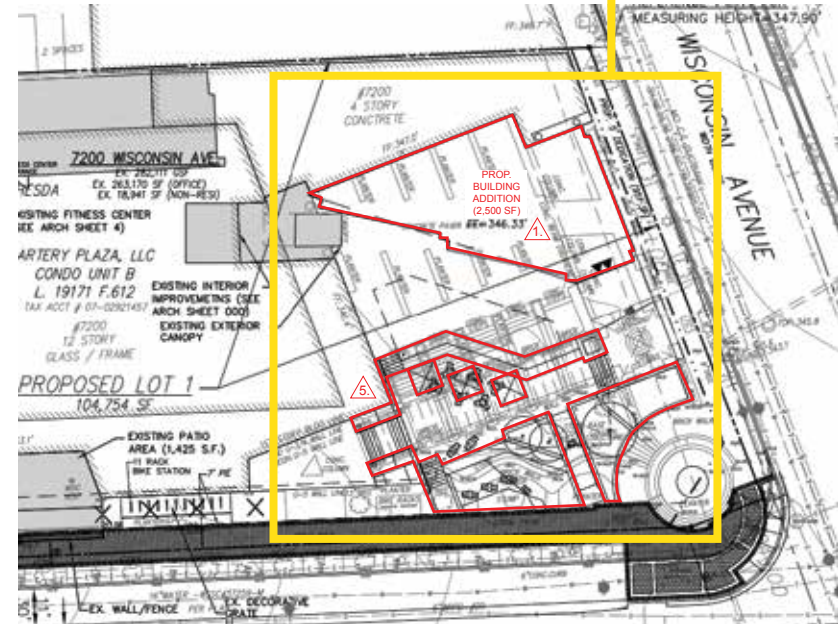

CLERICAL INFO

Use redlines to make any changes to clerical information that occur with the new amendment. These changes should not be included in the amendment list.

CERTIFICATIONS

Plan should have all approvals and certifications from the original plan. Changes to these elements should be shown with redlines, but do not need to be shown on the amendment list or with change triangles.

